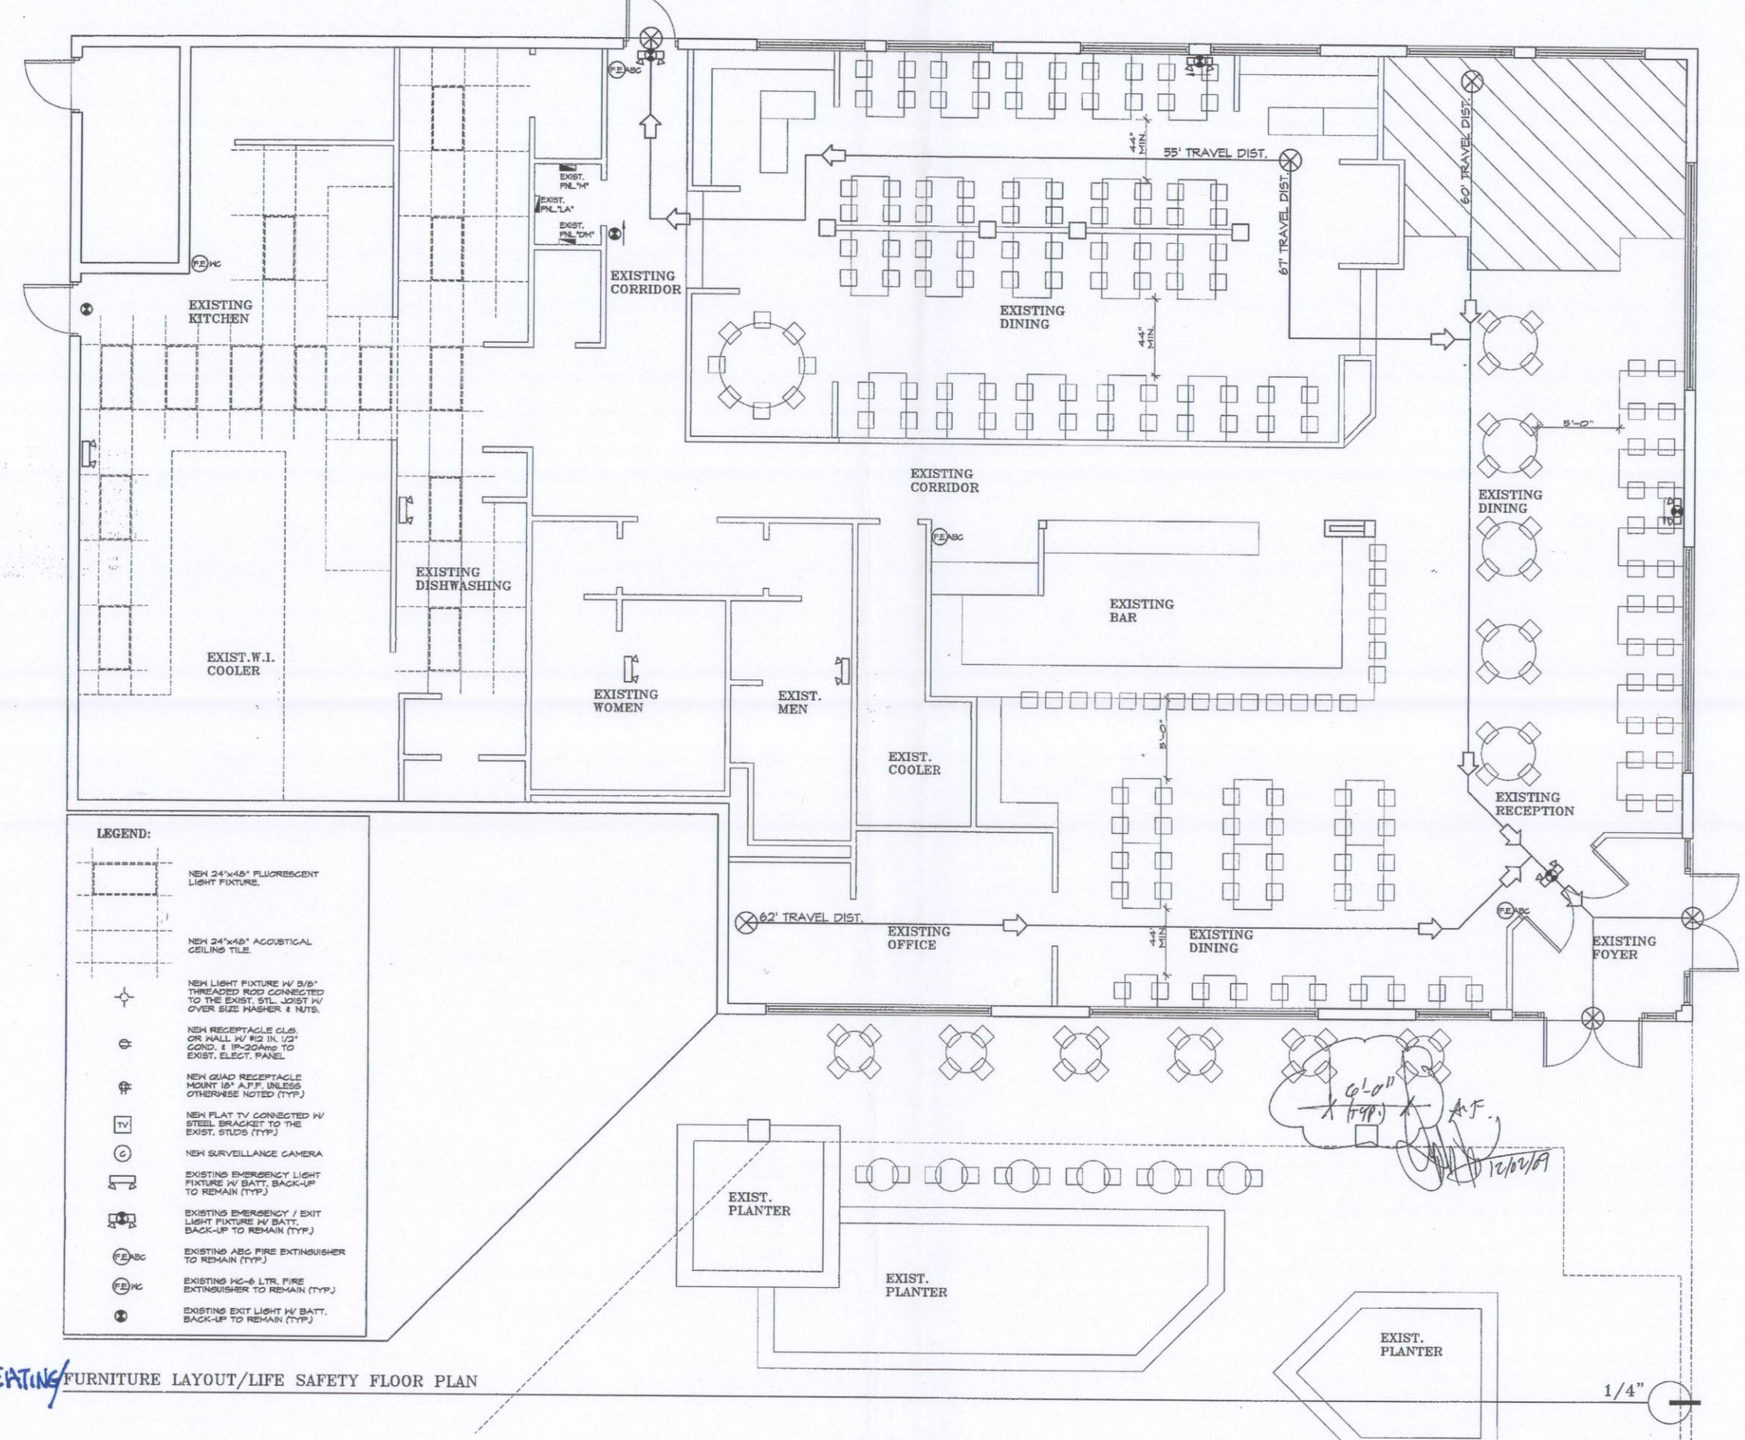

LEGEND:

- NEW 24"x48" FLUORESCENT LIGHT FIXTURE.
- NEW 24"x48" ACOUSTICAL CEILING TILE.
- NEW LIGHT FIXTURE W/ 5/8" THREADED ROD CONNECTED TO THE EXIST. STL. JOIST W/ OVER SIZE WASHER & NUTS.
- NEW RECEPTACLE CLG. OR WALL W/ #12 IN. 1/2" COND. & 1P-20Amp TO EXIST. ELECT. PANEL
- NEW QUAD RECEPTACLE MOUNT 18" A.F.F. UNLESS OTHERWISE NOTED (TYP.)
- TV — NEW FLAT TV CONNECTED W/ STEEL BRACKET TO THE EXIST. STUDS (TYP.)
- C — NEW SURVEILLANCE CAMERA
- EXISTING EMERGENCY LIGHT FIXTURE W/ BATT. BACK-UP TO REMAIN (TYP.)
- EXISTING EMERGENCY / EXIT LIGHT FIXTURE W/ BATT. BACK-UP TO REMAIN (TYP.)
- F.E. ABC — EXISTING ABC FIRE EXTINGUISHER TO REMAIN (TYP.)
- F.E. WC — EXISTING WC-6 LTR. FIRE EXTINGUISHER TO REMAIN (TYP.)
- EXISTING EXIT LIGHT W/ BATT. BACK-UP TO REMAIN (TYP.)

SEATING/FURNITURE LAYOUT/LIFE SAFETY FLOOR PLAN

FATHI ARCHITECTS, INC.
AA 0003068
IB 0001031
ARCHITECTS
INTERIORS
PLANNERS
5397 ORANGE DRIVE
SUITE 203
DAVIE, FLORIDA 33314
TEL: (954) 792-8230
FAX: (954) 792-8280
www.fathiarchitects.com

SEAL
ASGHAR J. FATHI, R.A.
AR0016048
11/30/09

CONSULTANT:

PROJECT:
AS-BUILT FOR:
DECO LOUNGE
606 E. HALLANDALE BEACH BLVD.
HALLANDALE, FLORIDA

OWNER:

ADDRESS:
606 E. HALLANDALE
BEACH BLVD.
HALLANDALE, FLORIDA

PHONE:

REVISIONS	DATE	BY

COPYRIGHT 1997, FATHI ARCHITECTS, INC. ALL RIGHTS RESERVED. ARCHITECTURE AND PLANS REMAINED AND PROTECTED BY THIS COPYRIGHT ARE OWNED BY THE ARCHITECT AND MAY NOT BE REPRODUCED OR USED IN ANY MANNER WITHOUT THE WRITTEN PERMISSION OF FATHI ARCHITECTS, INC. AND WHEN PERMITTED, THE SPECIFIC USE ON, AND IN CONNECTION WITH THIS SPECIFIED PROJECT, THEREIN SEAL, DESIGNS, ARRANGEMENTS AND PLANS ARE NOT TO BE USED, REPRODUCED, REPRODUCED, ALTERED, COPIED OR TRANSFERRED IN ANY FORM OR MANNER WHATSOEVER, WITHOUT THE SPECIFIC WRITTEN PERMISSION OF FATHI ARCHITECTS, INC.
WRITTEN DIMENSIONS ON THESE DRAWINGS SHALL HAVE PRECEDENCE OVER SCALED DIMENSIONS. CONTRACTOR SHALL VERIFY AND BE RESPONSIBLE FOR DIMENSIONS AND CONDITIONS ON THE JOB. FATHI ARCHITECTS, INC. MUST BE NOTIFIED IMMEDIATELY IN WRITING OF ANY VARIATION FROM THE DIMENSIONS AND CONDITIONS SHOWN BY THESE DRAWINGS. FIELD VERIFY ALL CONDITIONS PRIOR TO LAYING OUT OR EXPLICATING RESPECTED WORK.

DATE:	11/25/09
SCALE:	AS SHOWN
DRAWN:	R.R.
CHECKED:	A.F.
COMMISSION NO.:	24009

SHEET
A-4
SHEET NO. OF